

**FS301 Form**

**Forest Service Road Discontinue and Close Form**

This form is used to Discontinue and Close a Forest Service Road in accordance with the provisions of Section 121 (9) of the *Forest Act*.

File No. \_\_\_\_\_  
FSR Project No. \_\_\_\_\_

RESPONSIBLE PROGRAM: Natural Resource Operations \_\_\_\_ BCTS \_\_\_\_

Forest District \_\_\_\_\_

Natural Resource District \_\_\_\_\_

FSR NAME \_\_\_\_\_

and identified in the following manner: 8125.10

on the attached document or Exhibit A sketch dated \_\_\_\_\_

**DISCONTINUANCE AND CLOSURE APPROVED**

Please check to indicate the type of notice[s] that was given.

Please indicate the date or dates of notification: \_\_\_\_\_.

- |   |  |  |
|---|--|--|
| <input type="checkbox"/> District website         | <input type="checkbox"/> District Notice Board   | <input type="checkbox"/> Press Release / |
| <input type="checkbox"/> Stakeholder letter       | <input type="checkbox"/> On-Site Signage         | Press Package                            |
| <input type="checkbox"/> Newspaper                | <input type="checkbox"/> Email Distribution List | <input type="checkbox"/> Radio           |
| <input type="checkbox"/> TV ad                    | <input type="checkbox"/> FLNR website            | <input type="checkbox"/> Gov BC Website  |
| <input type="checkbox"/> Other [Please summarize] | _____  |  |

-----  
District Manager



-----  
Effective Date

\_\_\_\_\_  
Date Signed

Distribution: Senior Project Manager, Forest Land Acquisitions, Forest Tenures Branch, Victoria.  
Please attach a copy, photograph or summary of the Notice.



<b>MAP OF : 8125.10 (shown in bold black)</b>			
FOREST REGION : RSC FOREST DISTRICT : DCK	TSA : LAND DISTRICT : YDJD	PULPWOOD AGREEMENT :	MGT UNIT TYPE : Timber Supply Area MGT UNIT NO : 30
ESF NUMBER : MAP SHEET NUMBER : 92H.042	SCALE : 1:10,000 at ANSIA Size LENGTH (KM) : 1.9666	UTM ZONE: 10 NAD : 83	DRAWN BY : KV DATE : 2020-10-06

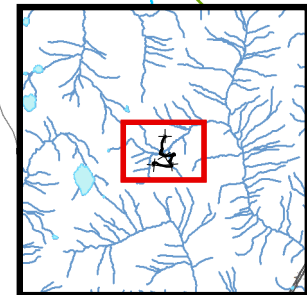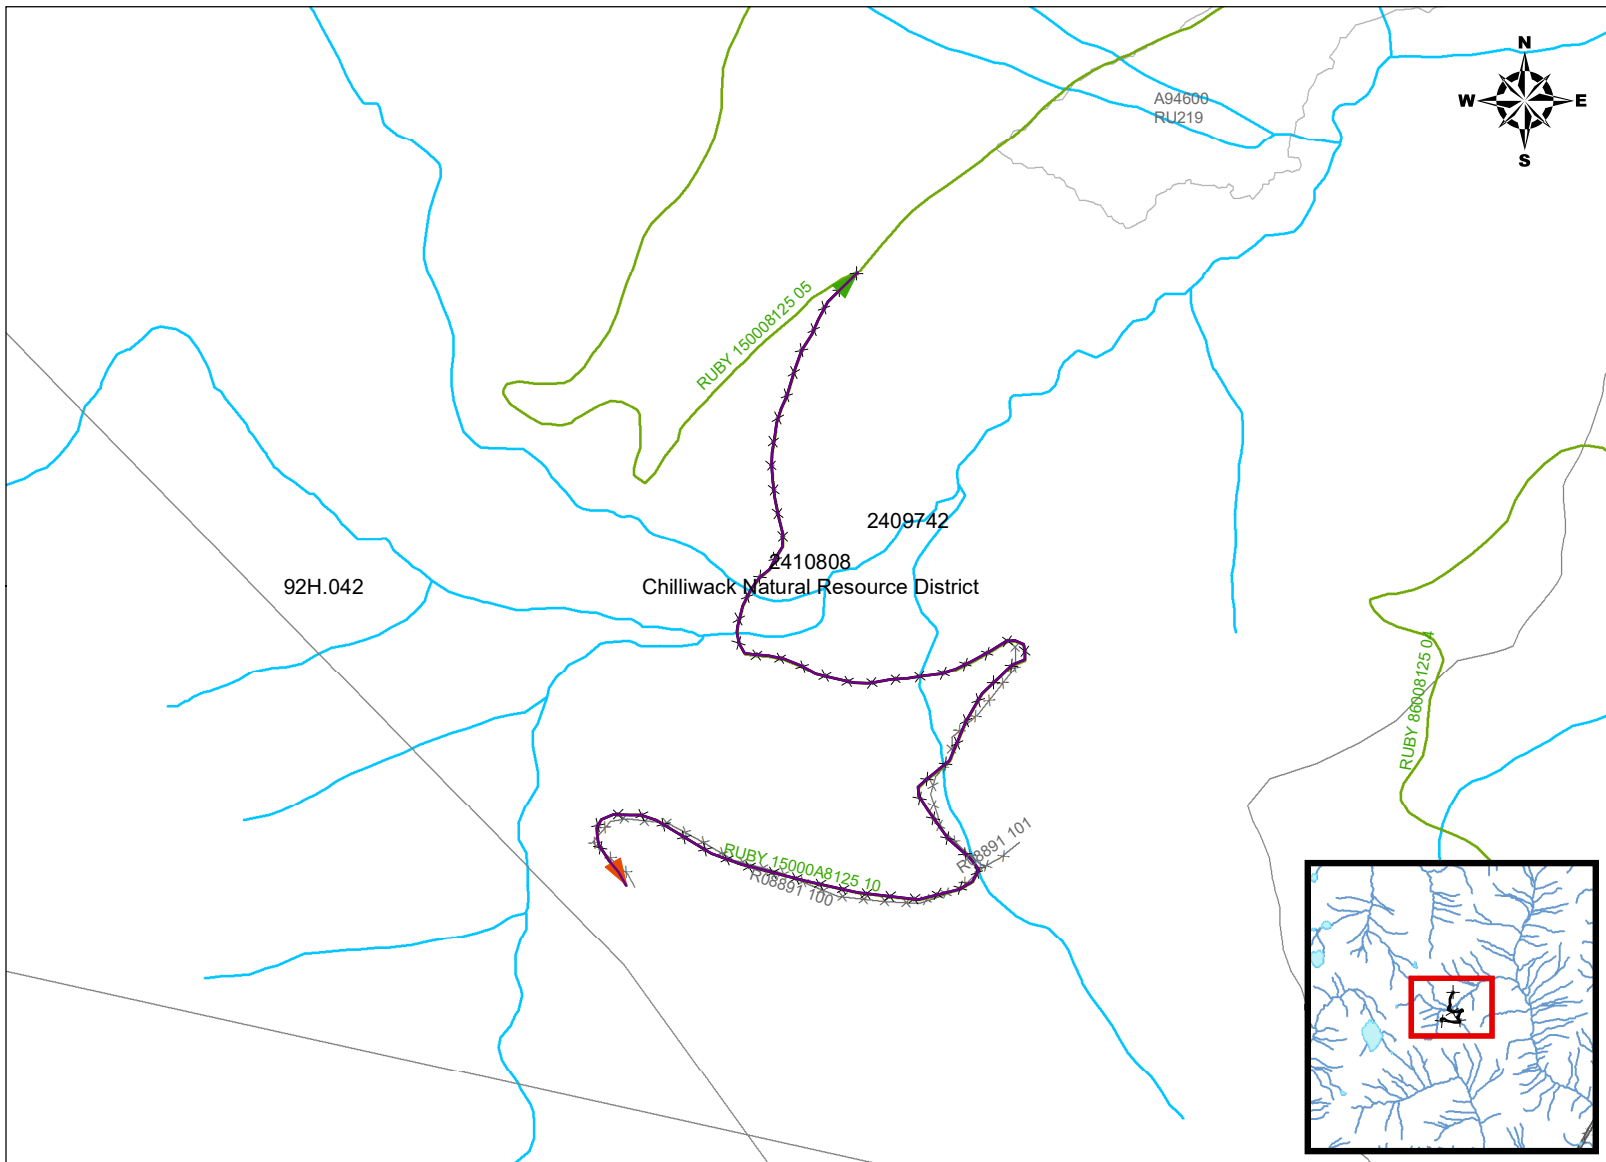

### Legend

- Tenure Application
- Tenure Road Application
- PoFC
- PoFT
- Retired Roads
- Crown Tenures
- Survey Parcels
- Right of Way
- Freeway
- Arterial/Collector Road
- Local Road
- Forest Service Roads
- Road Permits
- SUP Roads
- Recreation Lines
- Transmission lines
- Pipelines
- RAILWAY TRACKS
- Lakes/Rivers/Streams
- Recreation and Parks

1 cm : 2 km



## QRP Statement of Road Deactivation Conformance


TO BE COMPLETED BY QUALIFIED REGISTERED PROFESSIONAL AFTER COMPLETION OF THE ROAD DEACTIVATION WORKS

Road Name	Project #	Resource District/Business Area
8125.10		Chilliwack

I am a (check one)  Registered Forest Technologist,  Professional Engineer,  Professional Geoscientist or  Professional Forester, registered with the appropriate professional association in British Columbia, and I have undertaken professional responsibility for all field reviews<sup>1</sup> required with respect to this road deactivation project. I have taken steps as regulated under the Provincial Statute for my profession and as required by good practice, in order to sign and seal this Statement of Works Conformance.

In my professional opinion:

- the road deactivation work was carried out in general conformance with the road deactivation prescriptions for this project, including any other relevant documents and design amendments;
- sufficient field reviews of the work at the project site (considered necessary by me, and at my discretion, to confirm that the completed work is in general conformance with the accepted prescriptions and other supporting documents prepared for this project) have been carried out at appropriate times during the deactivation work by me or under my professional direction; and
- significant revisions to the prescriptions and supporting documents prepared for this project, including all prescription amendments, have been documented and recorded on a set of drawings (maps) marked "as-built" and, where necessary, described in supporting documents.

Signature of Qualified Registered Professional 		(please affix professional seal here)
Name of Qualified Registered Professional (please print) TREVOR SHANNON RFT 0633	Date Signed YYYY MM DD 2020 10 05	
EMPLOYER'S NAME AND ADDRESS (please print) BC TIMBER SALES, CHILWICK BA.		
Phone No.: 778-704-7099	Fax No:	Email address: TREVOR.SHANNON@GOV.BC.CA